


LEGEND

- [illegible]

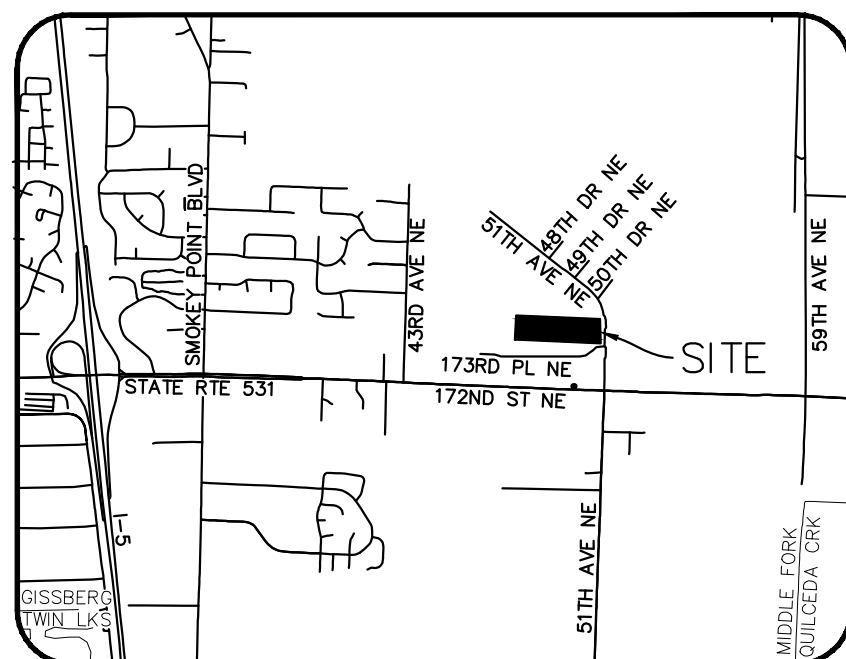

VICINITY MAP
NOT TO SCALE

50 0 25 50
1 INCH = 50 FT.

JOB NO.		20-69	
SHEET 1 OF 1			
AS-BUILT SURVEY		WASHINGTON	
SMARTCAP ARLINGTON AIRPORT		MARYSVILLE	
NORTH PEAK ASSOCIATES LLC		PROFESSIONAL LAND SURVEYORS	
17270 WOODVILLE REDMOND ROAD, NE, SUITE 705		WOODVILLE, WA 98072	
(206) 601-4682		WWW.NORTHPEAKASSOCIATES.COM	
DATE		01/18/22	
SCALE		1" = 50'	
DRAWN BY		ES	
CHECKED BY		SB	
NO		REVISION	
DATE			